



REPUBLIC OF THE PHILIPPINES
CIVIL AVIATION AUTHORITY OF THE PHILIPPINES
1101, PASAY CITY

THIS DRAWINGS IS EXCLUSIVE PROPERTIES OF CIVIL AVIATION AUTHORITY OF THE PHILIPPINES AND MUST NOT BE REPRODUCED, EXHIBITED, LOANED NOR COPIED IN PART OR IN WHOLE WITHOUT PROPER PERMISSION AND/OR WRITTEN CONSENT FROM THE DIRECTOR GENERAL CAAP.

AERODROME DEVELOPMENT AND MANAGEMENT SERVICE

INFRASTRUCTURE DEVELOPMENT AND DESIGN DIVISION

DESIGN STAFF:	INITIAL / DATE
DESIGNED BY:	
DRAWN BY:	
REVIEWED BY:	

CHECKED BY:
GLENN O. BELLO
 Acting Chief, Planning & Engineering Division

PREPARED BY:
ALGYLEN S. MENDOZA
 Architect

RECOMMENDED APPROVAL:
CRISTOPER ENRIQUEZ
 Officer-in-Charge, San Jose Airport

APPROVED:
GLENN D. TRIPULCA
 Civil Aviation Area Manager, Area Center III


NOTES/REVISIONS:

PROJECT:
AS-BUILT TERMINAL BUILDING

LOCATION:
**SAN JOSE AIRPORT
 SAN JOSE, OCCIDENTAL MINDORO**

SHEET CONTENTS:
AS SHOWN

DRAWING SCALE:	SHEET NO.:
AS SHOWN	

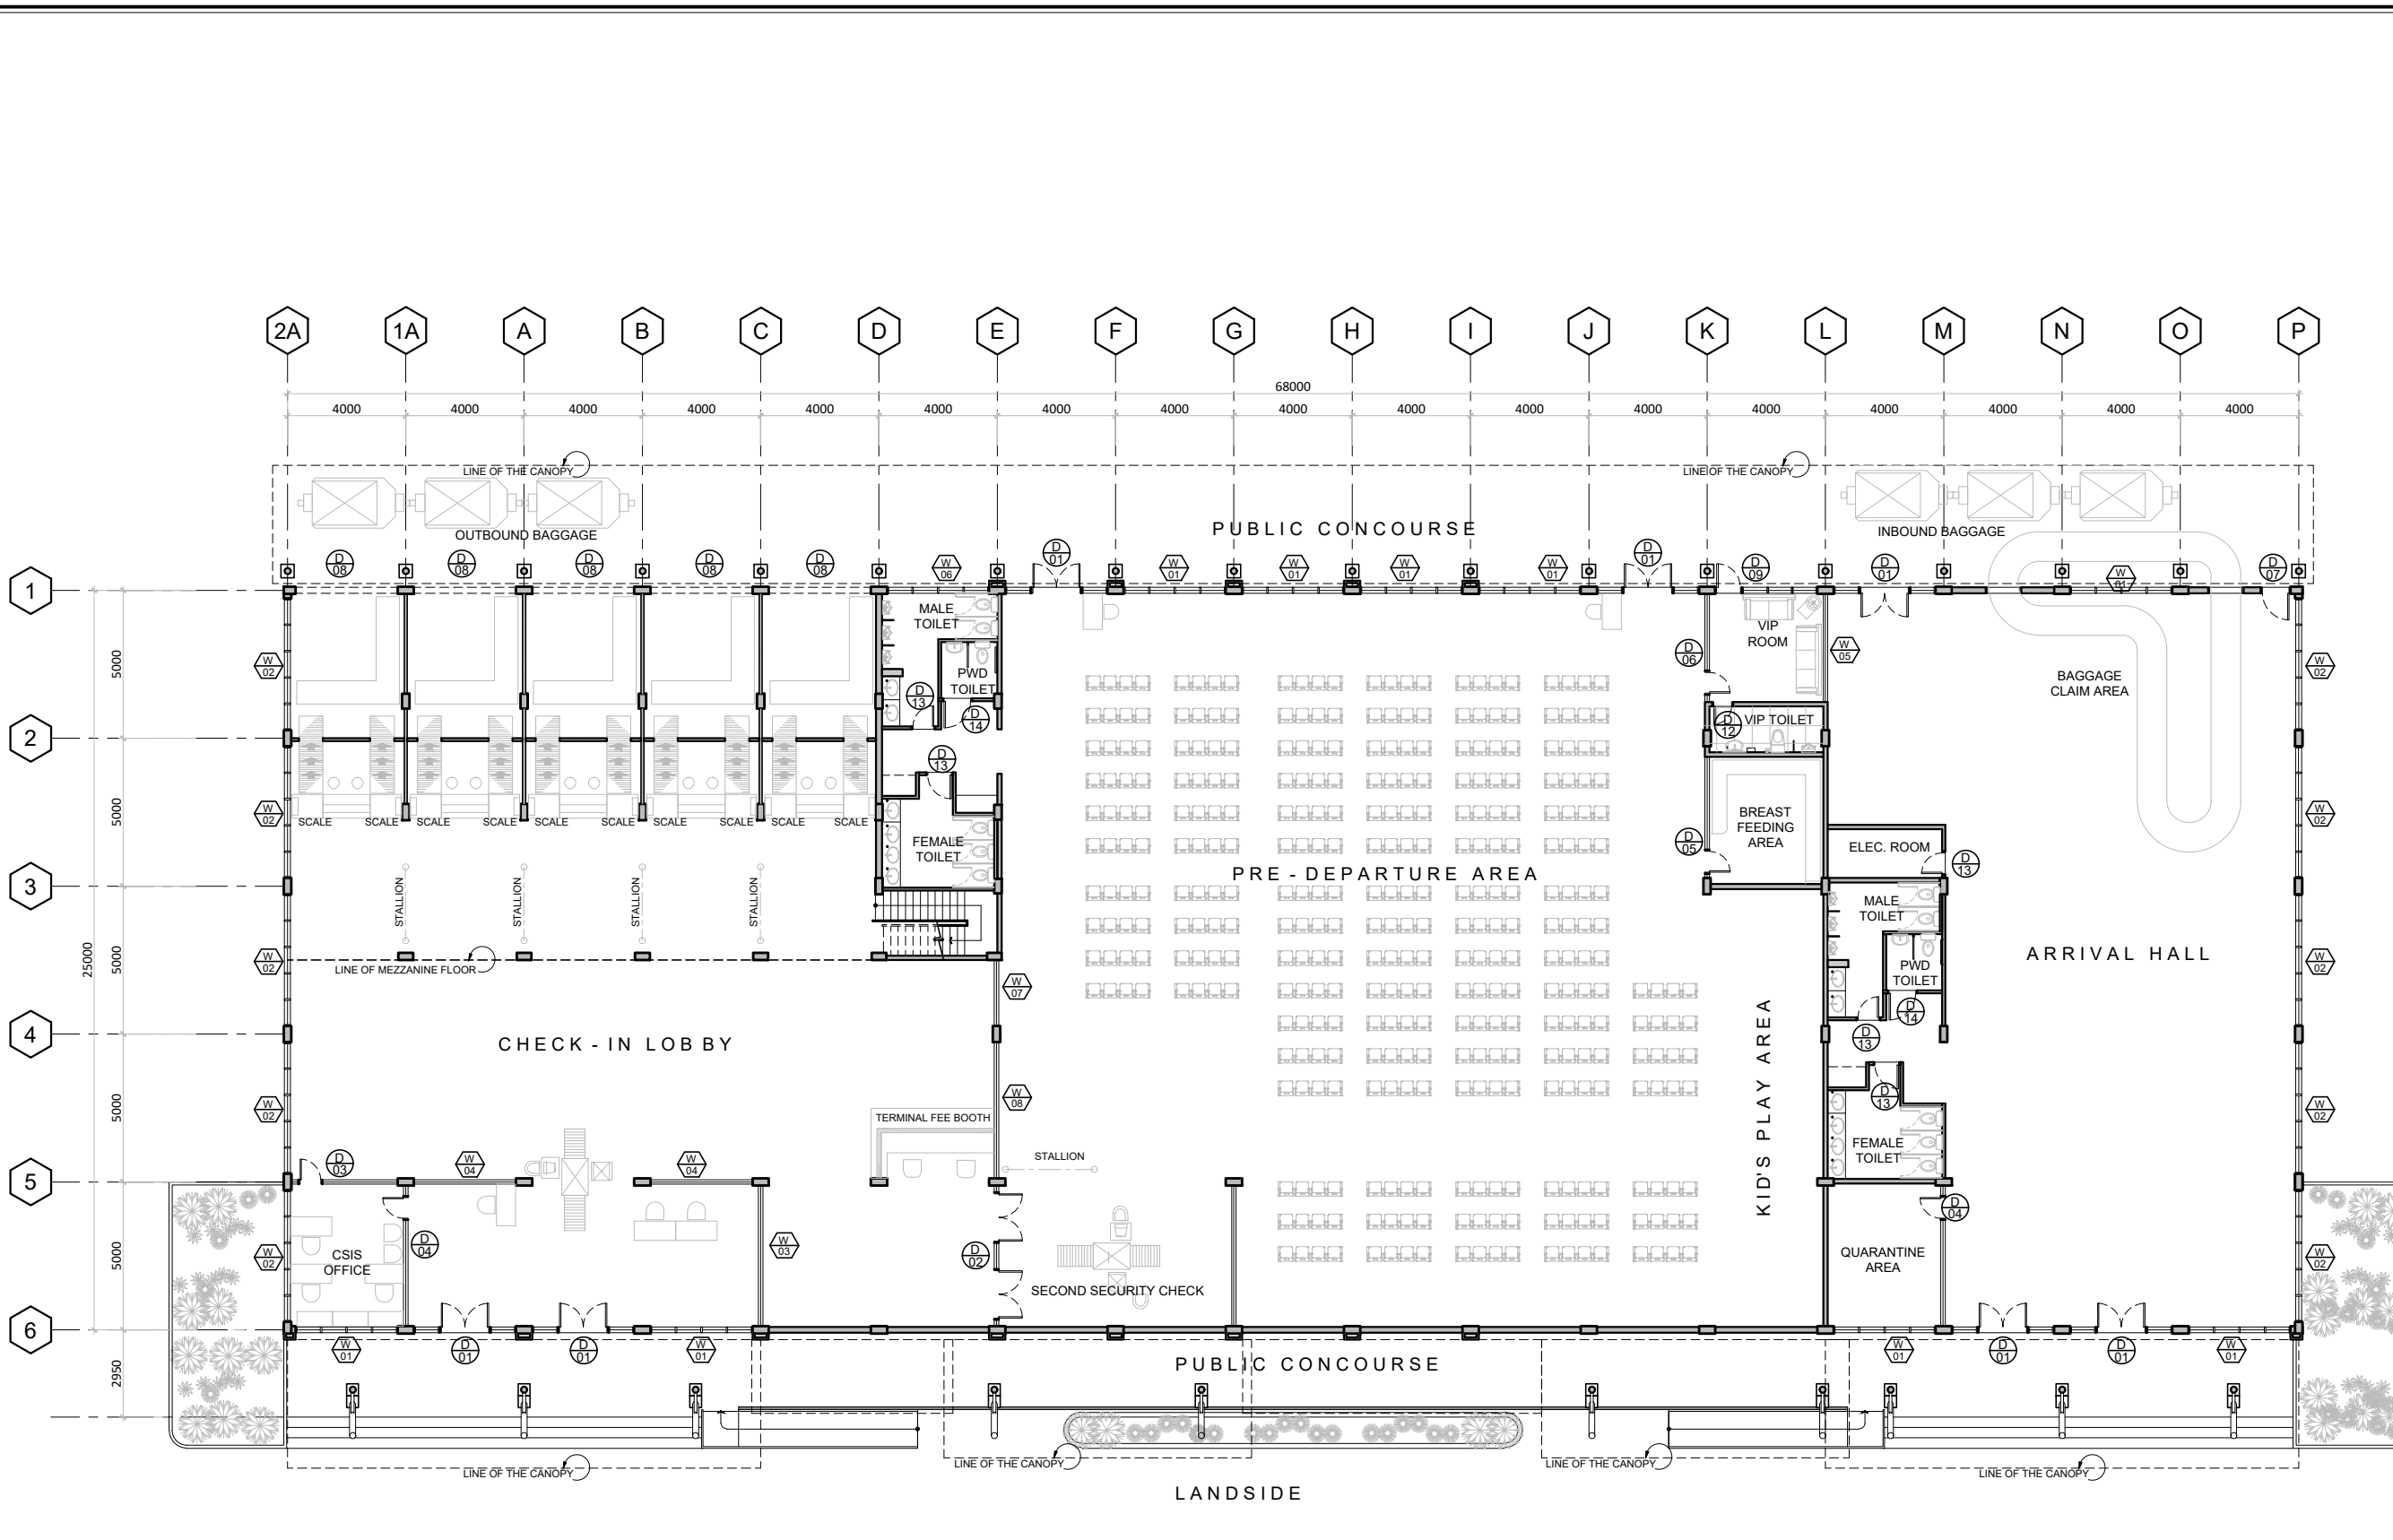

SAN JOSE AIRPORT-TERMINAL BUILDING
GROUND FLOOR PLAN
 SCALE 1:125 M.T.S



REPUBLIC OF THE PHILIPPINES
CIVIL AVIATION AUTHORITY OF THE PHILIPPINES
1000 ROAD, 1000 PASAY CITY

THIS DRAWINGS IS EXCLUSIVE PROPERTIES OF CIVIL AVIATION AUTHORITY OF THE PHILIPPINES AND MUST NOT BE REPRODUCED, EXHIBITED, LOANED NOR COPIED IN PART OR IN WHOLE WITHOUT PROPER PERMISSION AND/OR WRITTEN CONSENT FROM THE DIRECTOR GENERAL CAAP.

AERODROME DEVELOPMENT AND MANAGEMENT SERVICE

INFRASTRUCTURE DEVELOPMENT AND DESIGN DIVISION

DESIGN STAFF:	INITIAL / DATE
DESIGNED BY:	
DRAWN BY:	
REVIEWED BY:	

CHECKED BY:

GLENN O. BELLO
Acting Chief, Planning & Engineering Division

PREPARED BY:

ALGYLEN S. MENDOZA
Architect

RECOMMENDED APPROVAL:

CRISTOPER ENRIQUEZ
Officer-in-Charge, San Jose Airport

APPROVED:

GLENN D. TRIPULCA
Civil Aviation Area Manager, Area Center III

NOTES/REVISIONS:

PROJECT:

AS-BUILT TERMINAL BUILDING

LOCATION:

SAN JOSE AIRPORT
SAN JOSE, OCCIDENTAL MINDORO

SHEET CONTENTS:

AS SHOWN

DRAWING SCALE: SHEET NO:

AS SHOWN

